


LABOR AND MATERIALS

1	Copper	} Connection	3/4	\$
	Lead			
1	Curb	} Cock Valve T.S. & V.	3/4 in.	\$
1	Service box			
	Old returned			
			Short 3 1/2 x 4 1/2	
			Long 4 1/2 x 5 1/2	
12	Ft.	} Copper C.I. Galv.	3/4 in.	\$
	Nipples	in. at		\$
	Bushings	to in. at		\$
	Red'g	} Coupl'gs.	to in. at	\$
	Inc'g			
	Union	in. at		\$
	Meter	in. at		\$
				\$
	Compound Joints at			\$
	Maintenance Foreman			\$
	Hrs. Water Maint. Man—1 at			\$
	Hrs. Water Maint. Man—2 at			\$
	Hrs. Garage Foreman at			\$
	Hrs. Labor— at			\$
	Hrs. Compressor at			\$
				\$
	Trucking			\$
	Pav't Patch			\$
				\$
				\$
St. COOPER Ave. No. 126

Name of Owner CLEAR WATER

Labor and Mat'l. Report JUNE 21 1938

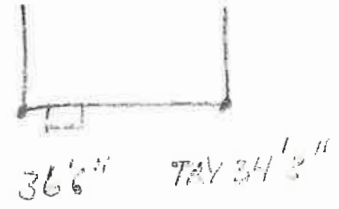

● Curb Box

6" Main Elev. of Main at tap 4 1/2'

Gate at ● ● Gate at

TAX ID #303.13-3-6

● Curb Box