

LABOR AND MATERIALS


1	Copper Lead	Connection	$\frac{3}{4}$ "	\$
1	Curb	Cock Valve	$\frac{3}{4}$ " in.	\$
	Same	T.S. & V.		
	Service box	Short $3\frac{1}{2}$ x $4\frac{1}{2}$	}	\$
	Old returned	Long $4\frac{1}{2}$ x $5\frac{1}{2}$		
24	$\frac{3}{4}$ " in.	Copper Pipe at		\$
		C.I.		
		C.I.		
	Nipples	in. at		\$
	Bushings	to in. at		\$
	Red'g	} Coupl'gs	to in. at	\$
	Inc'g			
	Union	in. at		\$
	Meter	in. at		\$
	Lead Joints	at		\$
	Compound Joints	at		\$
	Maintenance Foreman			\$
	Hrs. Water Maint. Man	—1 at		\$
	Hrs. Water Maint. Man	—2 at		\$
	Hrs. Garage Foreman	at		\$
	Hrs. Labor	at		\$
	Hrs. Compressor	at		\$
	Compensation Ins. at \$	per C		\$
	Trucking			\$
	Pav't Patch			\$
	Tap by Giffard & Co.			\$
				\$
				\$
	O'head			\$
				\$

Tap by Giffard & Co. 6-17-57

St. PL. Ave. No. 129

Name of Owner Somerville

Labor and Mat'l. Report June 17 1957

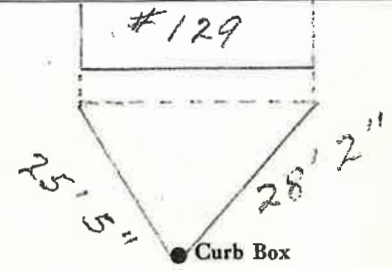

6" Main Elev. of Main at tap  $\frac{1}{2}$

Gate at ● Gate at

TAX ID # 303.9-15-5

● Curb Box