

LABOR AND MATERIALS


1	Copper	} Connection	3/4"	\$
1	Curb			
		} Cock Valve T.S. & V.	3/4 in.	\$
1	Service box	} Short 3 1/2 x 4 1/2 Long 4 1/2 x 5 1/2 Buff or Rdway		\$
	Old returned			
21	Ft. 3/4 in.			
	Nipples	in. at		\$
	Bushings	to in. at		\$
	Red'g			
	Inc'g	} Coupl'gs	to in. at	\$
	Union			
	Meter	in. at		\$
	Lead Joints	at		\$
	Compound Joints	at		\$
	Maintenance Foreman			\$
	Hrs. Water Maint. Man-1	at		\$
	Hrs. Water Maint. Man-2	at		\$
	Hrs. Garage Foreman	at		\$
	Hrs. Labor	at		\$
	Hrs. Compressor	at		\$
	Compensation Ins.	at \$ per C		\$
	Trucking			\$
	Pav't Patch			\$
	Tap made by Beecher & Co.			
	Oct. 2 - 1973			
	O'head			\$

CORTHLAND

Corthland St. Ave. No. 4

Name of Owner ORIA Bentley

Labor and Mat'l. Report Oct 2 1973

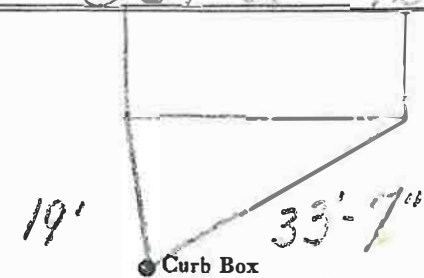

6" Main Elev. of Main at tap 4 1/2"

Gate at • Gate at

21' to main

• Curb Box

Tax Map #309.7-6-11