


LABOR AND MATERIALS

1	Copper	Connection	3/4"	\$
1	Curb	Cock Valve T.S. & V.	3/4 in. Cop to Cop	\$
1	Service box	Short 3 1/2 x 4 1/2	}	\$
Old returned	Long 4 1/2 x 5 1/2	Buff or Rdway		
8	Ft.	3/4 in. Copper C.I. C.I.	Pipe at	\$
	Nipples	in. at		\$
	Bushings	to in. at		\$
	Red'g } Inc'g	Coupl'gs	to in. at	\$
	Union	in. at		\$
	Meter	in. at		\$
	Lead Joints	at		\$
	Compound Joints	at		\$
	Maintenance Foreman			\$
	Hrs. Water Maint. Man-1	at		\$
	Hrs. Water Maint. Man-2	at		\$
	Hrs. Garage Foreman	at		\$
	Hrs. Labor	at		\$
	Hrs. Compressor	at		\$
	Compensation Ins.	at \$ per C		\$
	Trucking			\$
	Pav't Patch			\$
	TAP MADE BY GILFORD CO			\$
	O'head	Oct 22-1974		\$

St. 5
Ave. No. 5

Name of Owner Carthage
Morris Hikes
Labor and Mat'l. Report Oct. 22 1974

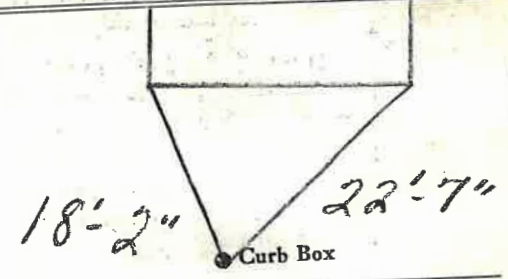

6" Main Elev. of Main at tap 5'
Gate at • Gate at •
8' to main
• Curb Box

Tax Map #309.7-7-13