


LABOR AND MATERIALS

1	Copper	} Connection <u>3/4"</u>	\$	
1	Lead			
1	Curb	} Cock <u>3/4" in.</u>	\$	
			T.S. & V.	
1	Service box	} Short 3 1/2 x 4 1/2	\$	
	Old returned			Long 4 1/2 x 5 1/2
				Buff or Rdway
27	Ft. <u>3/4</u> in.	} Pipe at	\$	
				Copper
				G.I.
		C.I.		
	Nipples	in. at	\$	
	Bushings	to in. at	\$	
	Red'g	} Coupl'gs to in. at	\$	
	Inc'g			
	Union	in. at	\$	
	Meter	in. at	\$	
	Lead Joints	at	\$	
	Compound Joints	at	\$	
	Maintenance Foreman		\$	
	Hrs. Water Maint. Man-1	at	\$	
	Hrs. Water Maint. Man-2	at	\$	
	Hrs. Garage Foreman	at	\$	
	Hrs. Labor	at	\$	
	Hrs. Compressor	at	\$	
	Compensation Ins.	at \$ per C	\$	
	Trucking		\$	
	Pav't Patch		\$	
	Tap by <u>Gifford & Co</u>		\$	
	<u>7-7-65</u>		\$	
	O'head		\$	
			\$	

Cortland St. Ave. No. 6

Name of Owner Orley Bentley

Labor and Mat'l. Report July 1 19 65

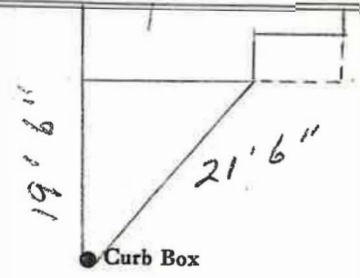

6" Main Elev. of Main at tap 5'

Gate at • Gate at

22' TO MAIN

● Curb Box

Tax Map #309.7-6-10