


LABOR AND MATERIALS

1	Copper Lead	Connection	3/4"	\$
1	Curb	Cock Valve T.S. & V.	1" in.	\$
1	Service box Old returned	Short 3 1/2 x 4 1/2 Long 4 1/2 x 5 1/2		\$
5	Ft. 1 in.	Copper G. I. Cst.	Pipe at	\$
	Nipples	in. at		\$
1	Bushings	1" to 1/2" in. at		\$
	Red'g Inc'g	Coupl'gs	to in. at	\$
	Union	in. at		\$
	Meter	in. at		\$
	Compound Joints	at		\$
	Maintenance Foreman			\$
	Hrs. Water Maint. Man	1 at		\$
	Hrs. Water Maint. Man	2 at		\$
	Hrs. Garage Foreman	at		\$
	Hrs. Labor	at		\$
	Hrs. Compressor	at		\$
	Trucking			\$
	Pav't Patch			\$
				\$
				\$
				\$
				\$

St. CRANDALL
~~St.~~
 Ave. No. 25

Name of Owner
NICHOL'S GARAGE

Labor and Mat'l. Report OCT 4 1924

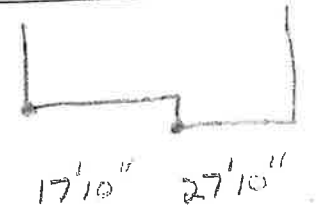

● Curb Box

Main Elev. of Main at tap
 Gate at ● ● Gate at

● Curb Box