


LABOR AND MATERIALS

1	Copper Lead	Connection	$\frac{3}{4}$	\$
1	Curb	Cock Valve T.S. & V.	1 in.	\$
1	Service box Old returned	Short $3\frac{1}{2} \times 4\frac{1}{2}$ Long $4\frac{1}{2} \times 5\frac{1}{2}$		\$
9	Ft.	Copper G.I. Cast	1 in. } Pipe at	\$
	Nipples		in. at	\$
1	Bushings		1" to $\frac{3}{4}$ " in. at	\$
	Red'g Inc'g	Coupl'gs	to in. at	\$
	Union		in. at	\$
	Meter		in. at	\$
	Compound Joints		at	\$
	Maintenance Foreman			\$
	Hrs. Water Maint. Man	1	at	\$
	Hrs. Water Maint. Man	2	at	\$
	Hrs. Garage Foreman		at	\$
	Hrs. Labor		at	\$
	Hrs. Compressor		at	\$
	Trucking			\$
	Pav't Patch			\$
				\$
				\$
				\$
				\$

St. CRANDALL  
~~Pl.~~  
 Ave. No. 31  
 Name of Owner  
 TAX ID # 309.27-3-10

Labor and Mat'l. Report JULY 3 1924

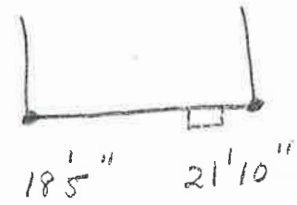

● Curb Box

10" Main      Elev. of Main at tap 4'  
 Gate at ●      ● Gate at

● Curb Box