

LABOR AND MATERIALS

3/4" Copper } Connection _____ \$
 Lead }
 3/4" Curb } Cock } _____ in. \$
 Valve }
 T. S. & V. }
 Service box { Short 3 1/2 x 4 1/2 }
 Old returned { Long 4 1/2 x 5 1/2 }
 14 Ft. 3/4" Copper } Pipe at _____ \$
 C.I. }
 Nipples in. at _____ \$
 3/4" Bushings to in. at _____ \$
 Red'g }
 Inc'g } Coupl'gs to in. at _____ \$
 Union in. at _____ \$
 Meter in. at _____ \$
 _____ \$
 Compound Joints at _____ \$
 Maintenance Foreman _____ \$
 Hrs. Water Maint. Man-1 at _____ \$
 Hrs. Water Maint. Man-2 at _____ \$
 Hrs. Garage Foreman at _____ \$
 Hrs. Labor- at _____ \$
 Hrs. Compressor at _____ \$
 _____ \$
 Trucking _____ \$
 Pav't Patch _____ \$
 _____ \$
 _____ \$
 _____ \$

St. _____
 Pt. _____
 Ave. No. 32
 CRANDALL

Name of Owner

Labor and Mat'l. Report

4/1/09
 JULY 7 1924


● Curb Box

Main

Elev. of Main at tap _____

Gate at ●

● Gate at

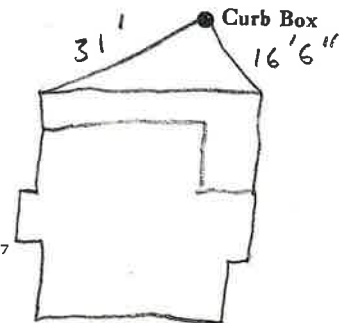

LSM-5C-6.1-67