

LABOR AND MATERIALS

Copper	} Connection		\$	
Lead				
Curb	} Cock Valve } T.S. & V. }	in.	\$	
Service box		} Short 3 1/2 x 4 1/2 } Long 4 1/2 x 5 1/2 }		\$
Old returned				\$
17 Ft.	} Copper } G.I. } G.I. }	3/4 in. Pipe at	\$	
Nipples		in. at	\$	
Bushings		to in. at	\$	
Red'g } Inc'g }	} Coupl'gs	to in. at	\$	
Union		in. at	\$	
Meter	in. at	\$		
Compound Joints	at	\$		
Maintenance Foreman		\$		
Hrs. Water Maint. Man-1	at	\$		
Hrs. Water Maint. Man-2	at	\$		
Hrs. Garage Foreman	at	\$		
Hrs. Labor	at	\$		
Hrs. Compressor	at	\$		
Trucking		\$		
Pav't Patch		\$		
		\$		
		\$		
		\$		
		\$		


CRANDALL

St. ~~Pl.~~ No. 38

Name of Owner

Labor and Mat'l. Report

1997

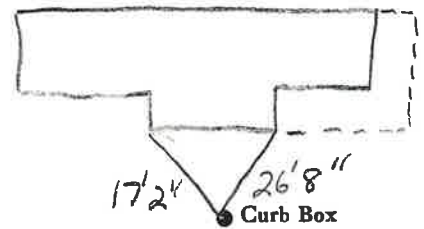

6" ORVILLE ST  
Main Elev. of Main at tap

Gate at • Gate at

• Curb Box