


LABOR AND MATERIALS

1	Copper	Connection	3"	\$
	Lead			
1	Curb	Cock Valve T.S. & V.	1" in.	\$
1	Service box	Short 3 1/2 x 4 1/2		
	Old returned	Long 4 1/2 x 5 1/2		
6	Ft. 3/4 in.	Copper G.I. Pipe at	10-25-12	\$
	Nipples	in. at		\$
	Bushings	1" to 1/2" in. at		\$
	Red'g Inc'g	Coupl'gs to in. at		\$
	Union	in. at		\$
	Meter	in. at		\$
	Compound Joints	at		\$
	Maintenance Foreman			\$
	Hrs. Water Maint. Man	—1 at		\$
	Hrs. Water Maint. Man	—2 at		\$
	Hrs. Garage Foreman	at		\$
	Hrs. Labor	at		\$
	Hrs. Compressor	at		\$
	Trucking			\$
	Pav't Patch			\$
				\$
				\$
CRANDALL St. Pl. Ave. No. 51

Name of Owner

Labor and Mat'l. Report SEPT. 23 1924

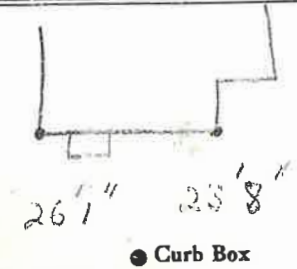

10" Main Elev. of Main at tap 4' Gate at • Gate at •

• Curb Box

TAX ID # 302.20-14-17