

LABOR AND MATERIALS

1	Copper	} Connection	3/4"	\$
1	Lead			
1	Curb	} Cock Valve	3/4 in.	\$
1	Service box	} Short 3 1/2 x 4 1/2		\$
	Old returned			
7	Ft. 3/4 in.	} Copper	} Pipe at	\$
	Nipples	in. at	\$	
	Bushings	to in. at	\$	
	Red'g	} Coupl'gs	to in. at	\$
	Inc'g			
	Union	in. at	\$	
	Meter	in. at	\$	
	Lead Joints	at	\$	
	Compound Joints	at	\$	
	Maintenance Foreman		\$	
	Hrs. Water Maint. Man-1	at	\$	
	Hrs. Water Maint. Man-2	at	\$	
	Hrs. Garage Foreman	at	\$	
	Hrs. Labor	at	\$	
	Hrs. Compressor	at	\$	
	Compensation Ins. at \$	per C	\$	
	Trucking		\$	
	Pav't Patch		\$	
	TAP MADE BY GIFFORD			\$
	+ PURVIS			\$
	O'head	MAX-20-1973	\$	
			\$	


CRANDALL St. Ave. No. 53

Name of Owner

VAN HANSEN

Labor and Mat'l. Report

MAR 20 1973

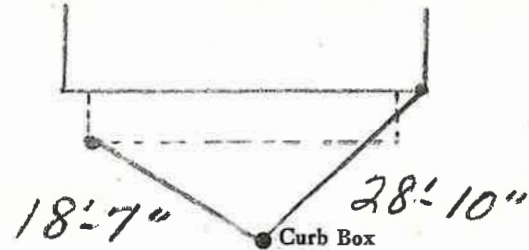

10" Main

Elev. of Main at tap 5'

Gate at ●

● Gate at

TAX ID # 302.20-14-16

● Curb Box