


LABOR AND MATERIALS

1	Copper Lead	} Connection $\frac{3}{4}$ "	\$
1	Curb		} Cock Valve T.S. & V. } 1" in.
1	Service box Old returned	} Short $3\frac{1}{2}$ x $4\frac{1}{2}$ } Long $4\frac{1}{2}$ x $5\frac{1}{2}$ }	
18	Ft. 1" in.		} Copper G. I. } Pipe at
	Nipples	in. at	
1	Bushings	1" to $\frac{1}{2}$ " in. at	\$
	Red'g Inc'g	} Coupl'gs. to in. at	\$
	Union		in. at
	Meter	in. at	\$
	Compound Joints	at	\$
	Maintenance Foreman		\$
	Hrs. Water Maint. Man-1	at	\$
	Hrs. Water Maint. Man-2	at	\$
	Hrs. Garage Foreman	at	\$
	Hrs. Labor	at	\$
	Hrs. Compressor	at	\$
	Trucking		\$
	Pav't Patch		\$
			\$
			\$
St. CRANDALL
~~Pr.~~ No. 54

Name of Owner _____

Labor and Mat'l. Report SEPT 23 1924

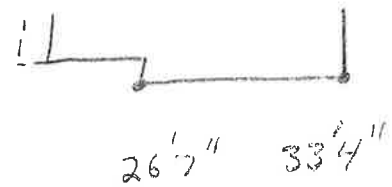

● Curb Box

10" Main Elev. of Main at tap 4 1/2'

Gate at ● ● Gate at

● Curb Box