


LABOR AND MATERIALS

Copper	} Connection		\$	
Lead				
Curb	} Cock } Valve } T. S. & V.	in.	\$	
Service box		} Short 3½ x 4½ } Long 4½ x 5½		
Old returned				\$
19 Ft. ¾ in.	} Copper } C.I.P. } C.I.P.	Pipe at	\$	
Nipples	in. at		\$	
Bushings	to in. at		\$	
Red'g	} Coupl'gs	to in. at	\$	
Inc'g				
Union	in. at		\$	
Meter	in. at		\$	
			\$	
Compound Joints	at		\$	
Maintenance Foreman			\$	
Hrs. Water Maint. Man-1	at		\$	
Hrs. Water Maint. Man-2	at		\$	
Hrs. Garage Foreman	at		\$	
Hrs. Labor	at		\$	
Hrs. Compressor	at		\$	
			\$	
Trucking			\$	
Pav't Patch			\$	
			\$	
			\$	
			\$	
			\$	

St. CRANDALL
 Pl. 60
 Ave. No. 60
 Name of Owner

Labor and Mat'l. Report SEPT. 20 1924

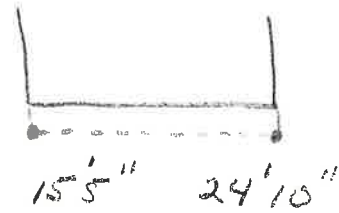

● Curb Box

10" Main Elev. of Main at tap 4'
 Gate at ● Gate at

● Curb Box

¾" COPPER - 1998