


LABOR AND MATERIALS

1 Copper } Connection 3/4" \$
 Lead }
 1 Curb } Cock Valve } 3/4" (MAY 21 1974) \$
 F.S. & V. }
 1 Service box } Short 3 1/2 x 4 1/2 } \$
 Old returned } Long 4 1/2 x 5 1/2 }
 Bush or Redway }
 20 3/4 Ft. in. } Copper } Pipe at \$
 } }
 Nipples in. at \$
 Bushings to in. at \$
 Red'g }
 Inc'g } Coupl'gs to in. at \$
 Union in. at \$
 Meter in. at \$
 Lead Joints at \$
 Compound Joints at \$
 Maintenance Foreman \$
 Hrs. Water Maint. Man-1 at \$
 Hrs. Water Maint. Man-2 at \$
 Hrs. Garage Foreman at \$
 Hrs. Labor at \$
 Hrs. Compressor at \$
 Compensation Ins. at \$ per C \$
 Trucking \$
 Pav't Patch \$
 TH R MADE BY GIFFORD \$
 14 Co \$
 Aug 5 1974 \$
 O'head \$
 \$

CRANDALL St. No. 681

Name of Owner RONALD RAYNOX

Labor and Mat'l. Report Aug 5 1974

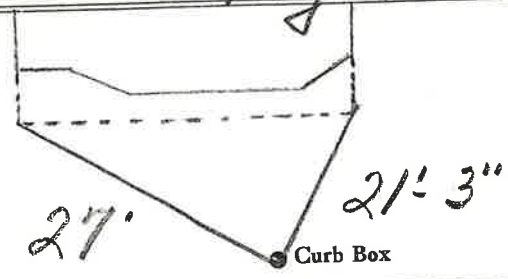

10" Main Elev. of Main at tap 5 1/2'

Gate at • Gate at •

• Curb Box