

LABOR AND MATERIALS


Copper	}	Connection		\$	
Lead					
Curb	}	Cock	in.	\$	
		Valve			
		T. S. & V.			
Service box	}	Short 3½ x 4½		\$	
Old returned		Long 4½ x 5½			
		Buff or Rdway			
26' ³ / ₄	}	Copper	in.	\$	
		C.I.			
		Pipe at			
Nipples		in. at		\$	
Bushings		to in. at		\$	
Red'g	}	Coupl'gs	to in. at	\$	
Inc'g					
Union		in. at		\$	
Meter		in. at		\$	
Lead Joints		at		\$	
Compound Joints		at		\$	
Maintenance Foreman				\$	
Hrs. Water Maint. Man-1		at		\$	
Hrs. Water Maint. Man-2		at		\$	
Hrs. Garage Foreman		at		\$	
Hrs. Labor		at		\$	
Hrs. Compressor		at		\$	
Compensation Ins. at \$		per C		\$	
Trucking				\$	
Pav't Patch				\$	
				\$	
				\$	
O'head				\$	
				\$	

St. PL
Ave. No. 86

CRANDALL

Name of Owner
Peter DiManno

Labor and Mat'l. Report AUG 1982

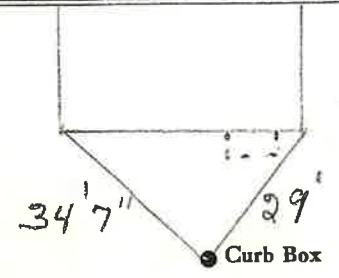

Main Elev. of Main at tap

Gate at • • Gate at

• Curb Box

**OLD SERVICE
TO BE DISCONTINUED**