


# LABOR AND MATERIALS

3/4 Copper } Connection \_\_\_\_\_ \$ \_\_\_\_\_  
 Lead }  
 Curb } Cock } \_\_\_\_\_ in. \$ \_\_\_\_\_  
 Valve }  
 T.S. & V. }  
 Service box { Short 3-1/2 x 4-1/2 } \_\_\_\_\_ \$ \_\_\_\_\_  
 Old returned { Long 4-1/2 x 5-1/2 } \_\_\_\_\_ \$ \_\_\_\_\_  
 1/1 Ft. \_\_\_\_\_ in. { Copper } Pipe at \_\_\_\_\_ \$ \_\_\_\_\_  
 { G.I. }  
 { C.I. }  
 Nipples \_\_\_\_\_ in. at \_\_\_\_\_ \$ \_\_\_\_\_  
 Bushings \_\_\_\_\_ to \_\_\_\_\_ in. at \_\_\_\_\_ \$ \_\_\_\_\_  
 Red'g \_\_\_\_\_  
 Inc'g \_\_\_\_\_  
 Union \_\_\_\_\_ in. at \_\_\_\_\_ \$ \_\_\_\_\_  
 Meter \_\_\_\_\_ in. at \_\_\_\_\_ \$ \_\_\_\_\_  
 \_\_\_\_\_ \$ \_\_\_\_\_  
 Compound Joints at \_\_\_\_\_ \$ \_\_\_\_\_  
 Maintenance Foreman \_\_\_\_\_ \$ \_\_\_\_\_  
 Hrs. Water Maint. Man - 1 at \_\_\_\_\_ \$ \_\_\_\_\_  
 Hrs. Water Maint. Man - 2 at \_\_\_\_\_ \$ \_\_\_\_\_  
 Hrs. Garage Foreman \_\_\_\_\_ at \_\_\_\_\_ \$ \_\_\_\_\_  
 Hrs. Labor \_\_\_\_\_ at \_\_\_\_\_ \$ \_\_\_\_\_  
 Hrs. Compressor at \_\_\_\_\_ \$ \_\_\_\_\_  
 \_\_\_\_\_ \$ \_\_\_\_\_  
 Trucking \_\_\_\_\_ \$ \_\_\_\_\_  
 Pav't Patch \_\_\_\_\_ \$ \_\_\_\_\_  
 \_\_\_\_\_ \$ \_\_\_\_\_  
 \_\_\_\_\_ \$ \_\_\_\_\_  
Crandell St  
Pl.  
Ave. No. 109  
 Name of Owner \_\_\_\_\_

Labor and Mat'l. Report 19

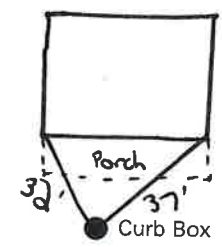

\_\_\_\_\_ Main Elev. of  
Main at tap \_\_\_\_\_  
 Gate at ● ● Gate at  
 \_\_\_\_\_  
 ● Curb Box

*Save 20' OF SDE 35*


LABOR AND MATERIALS

1	Copper	Connection	1"	\$
1	Lead	Cock		\$
1	Curb	Valve	1 in.	\$
		T.S. & V.		\$
1	Service box	Short 3 1/2 x 4 1/2		\$
	Old returned	Long 4 1/2 x 5 1/2		\$
		Buff or Rdway		\$
11	Ft.	Copper	Pipe at	\$
	1 in.	C.I.		\$
		C.I.		\$
	Nipples	in. at		\$
	Bushings	to in. at		\$
	Red'g			\$
	Inc'g	Coupl'gs. to in. at		\$
	Union	in. at		\$
	Meter	in. at		\$
	Lead Joints	at		\$
	Compound Joints	at		\$
	Maintenance Foreman			\$
	Hrs. Water Maint. Man	1 at		\$
	Hrs. Water Maint. Man	2 at		\$
	Hrs. Garage Foreman	at		\$
	Hrs. Labor	at		\$
	Hrs. Compressor	at		\$
	Compensation Ins.	at \$ per C		\$
	Trucking			\$
	Pav't Patch			\$
	Tap by Gifford & Co.			\$
	4-19-67.			\$
	O'head			\$

Grandall St. No. 109  
Pl. Ave. No.

Name of Owner  
Binley Florists Inc.

Labor and Mat'l. Report Apr. 19 1967

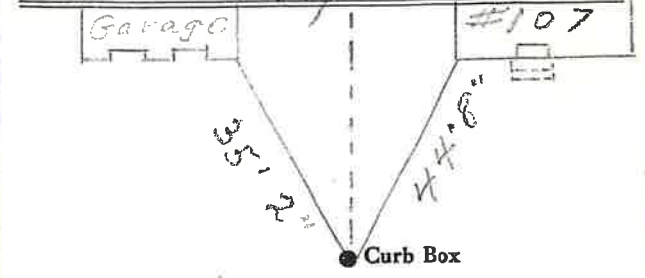

10" Main Elev. of Main at tap 4'  
Gate at • Gate at

• Curb Box  
1" Tap on Grandall St.  
For Green Houses


RAZED 1997

### LABOR AND MATERIALS

3/4" Copper } Connection \_\_\_\_\_ \$ \_\_\_\_\_  
 Lead }  
 Curb } Cock } \_\_\_\_\_ in. \_\_\_\_\_ \$ \_\_\_\_\_  
 Valve }  
 T.S. & V. }  
 Service box { Short 3-1/2 x 4-1/2 } \_\_\_\_\_ \$ \_\_\_\_\_  
 Old returned { Long 4-1/2 x 5-1/2 }  
 11' Ft. 2" in. { Copper } Pipe at \_\_\_\_\_ \$ \_\_\_\_\_  
 Gal. }  
 Nipples \_\_\_\_\_ in. at \_\_\_\_\_ \$ \_\_\_\_\_  
 Bushings \_\_\_\_\_ to \_\_\_\_\_ in. at \_\_\_\_\_ \$ \_\_\_\_\_  
 Red'g \_\_\_\_\_  
 Inc'g \_\_\_\_\_  
 Union \_\_\_\_\_ in. at \_\_\_\_\_ \$ \_\_\_\_\_  
 Meter \_\_\_\_\_ in. at \_\_\_\_\_ \$ \_\_\_\_\_  
 \_\_\_\_\_ \$ \_\_\_\_\_  
 Compound Joints at \_\_\_\_\_ \$ \_\_\_\_\_  
 Maintenance Foreman \_\_\_\_\_ \$ \_\_\_\_\_  
 Hrs. Water Maint. Man - 1 at \_\_\_\_\_ \$ \_\_\_\_\_  
 Hrs. Water Maint. Man - 2 at \_\_\_\_\_ \$ \_\_\_\_\_  
 Hrs. Garage Foreman \_\_\_\_\_ at \_\_\_\_\_ \$ \_\_\_\_\_  
 Hrs. Labor \_\_\_\_\_ at \_\_\_\_\_ \$ \_\_\_\_\_  
 Hrs. Compressor at \_\_\_\_\_ \$ \_\_\_\_\_  
 \_\_\_\_\_ \$ \_\_\_\_\_  
 Trucking \_\_\_\_\_ \$ \_\_\_\_\_  
 Pav't Patch \_\_\_\_\_ \$ \_\_\_\_\_  
 \_\_\_\_\_ \$ \_\_\_\_\_  
 \_\_\_\_\_ \$ \_\_\_\_\_  
 \_\_\_\_\_ \$ \_\_\_\_\_  
 \_\_\_\_\_ \$ \_\_\_\_\_

St. \_\_\_\_\_  
 Pl. \_\_\_\_\_  
 Ave. No. 109  
 Name of Owner CRANDALL

Labor and Mat'l. Report ~~18~~ 3/2006

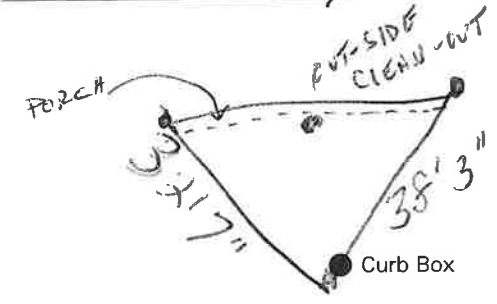

\_\_\_\_\_ Main Elev. of Main at tap \_\_\_\_\_  
 Gate at ● Gate at ●  
 ● Curb Box

SEWER  
 20' CLEAN-OUT to MAIN  
 4" SEWER