


LABOR AND MATERIALS

1	Copper	} Connection $\frac{3}{4}$	\$
	Lead		
1	Curb	} Cock Valve } $\frac{3}{4}$ in.	\$
			} T.S. & V.
1	Service box	} Short $3\frac{1}{2} \times 4\frac{1}{2}$ Long $4\frac{1}{2} \times 5\frac{1}{2}$	\$
	Old returned		
22	Ft. $\frac{3}{4}$ in.	} Copper G.I. G.I.	\$
	Nipples	in. at	\$
1	Bushings	$\frac{3}{4}$ to $\frac{1}{2}$ in. at	\$
1	Red'g	} Coupl'gs	\$
	Inc'g		
	Union	in. at	\$
	Meter	in. at	\$
	Compound Joints	at	\$
	Maintenance Foreman		\$
	Hrs. Water Maint. Man-1	at	\$
	Hrs. Water Maint. Man-2	at	\$
	Hrs. Garage Foreman	at	\$
	Hrs. Labor	at	\$
	Hrs. Compressor	at	\$
	Trucking		\$
	Pav't Patch		\$
			\$
			\$
			\$
			\$

St. CRANDALL  
~~Pr~~  
 Ave. No. 112

Name of Owner

Labor and Mat'l. Report JUNE 23 1927

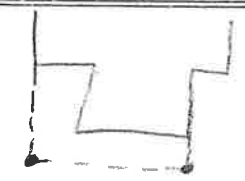

36'9" 31'9"  
 ● Curb Box

10" Main Elev. of Main at tap 5'  
 Gate at ● Gate at ●

● Curb Box

OLD TAP SHUT OFF