

LABOR AND MATERIALS

Copper	}	Connection			\$
Lead					
Curb	{	Cock Valve			\$
		T. S. & V.			\$
Service Box		Short 3/2x4 1/2			\$
Old returned	}	Long 4 1/2x5 1/2			\$
		Buff. or Rdway			\$
Ft. $\frac{3}{4}$	{	Copper			\$
		Cast Iron			
in.		Cast Iron			
Nipples				\$	
Bushings				\$	
Red'g Inc'g	}	Couplings			\$
					\$
Union				\$	
Meter				\$	
Lead Joints				\$	
Leadite Joints				\$	
Hrs. Foreman				\$	
Hrs. Chauffeur				\$	
Hrs. Tapper				\$	
Hrs. Labor				\$	
Hrs. Labor				\$	
Hrs. Compressor				\$	
Compensation Ins.				\$	
Trucking				\$	
Builders Use of Water				\$	
				\$	
				\$	
				\$	
				\$	


St.
Pr.
Ave. No. 116

Crandall

Name of Owner

Labor and Mat'l. Report

1912

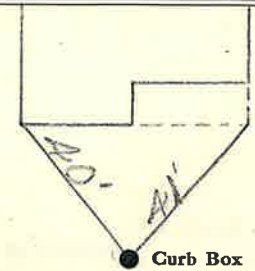

Main Elev. of Main at top

Gate at ● ● Gate at

● Curb Box

RENEWAL TAP - 1927
TAP ON CRANDALL