

LABOR AND MATERIALS

1	Copper Lead	} Connection	$\frac{3}{4}$		\$.....
1	Curb	{ Cock Valve T-S. & V.	$\frac{3}{4}$	in.	\$.....
1	Service Box Old returned	{ Short 3"x4" Long 4"x5" Buff for Rdway			\$.....
23	Ft.	$\frac{3}{4}$ in.	{ Copper Galv Iron Cast Iron	} Pipe at	\$.....
	Nipples in. at			\$.....
	Bushings to		in. at	\$.....
1	Redg Inchg	} Couplings	$\frac{3}{4}$	to	\$.....
	Union in. at			\$.....
	Meter in. at			\$.....
	Lead Joints at				\$.....
	Leadite Joints at				\$.....
	Hrs. Foreman at				\$.....
	Hrs. Chauffeur at				\$.....
	Hrs. Tapper at				\$.....
	Hrs. Labor at				\$.....
	Hrs. Labor at				\$.....
	Hrs. Compressor at				\$.....
	Compensation Ins.				\$.....
	Trucking				\$.....
	Builders Use of Water				\$.....
					\$.....
					\$.....
VACANT LOT


Grandall

St. 122
Pt.
Ave. No. 1202

Name of Owner

TAP MADE JUNE 10, 1927

Labor and Mat'l. Report AUG 24 1939 19

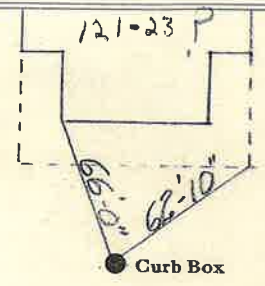

10' Main

Elev. of
Main at tap 5'

Gate at ●

● Gate at

● Curb Box