


LABOR AND MATERIALS

1	Copper Lead	Connection	2"	\$	23.34
1	Curb	Cock Valve T.S. & V.	2 in.	\$	21.33
1	Service box Old returned	Short 3 1/2 x 4 1/2 Long 4 1/2 x 5 1/2 Buff or Rdway		\$	11.09
14	Ft. 2 in.	Copper G.I. G.I.	Pipe at	1.77	\$ 24.78
	Nipples	in. at		\$	
	Bushings	to in. at		\$	
	Red'g Inc'g	Coupl'gs to in. at		\$	
	Union	in. at		\$	
	Meter	in. at		\$	
	Lead Joints at			\$	
	Compound Joints at			\$	
3	Maintenance Foreman			\$	5.81
	Hrs. Water Maint. Man	1 at		\$	
8	Hrs. Water Maint. Man	2 at		\$	12.90
8	Hrs. Garage Foreman	labor at		\$	11.85
8	Hrs. Labor	at 1.30		\$	10.40
	Hrs. Compressor at			\$	
	Compensation Ins. at	\$ 5.686 per C		\$	7.33
	Trucking			\$	1.50
	Pav't Patch			\$	11.20
	Tap by G. J. G. & P.			\$	
	Per 4/25/56			\$	
	O'head			\$	
				\$	136.53

St. Pl. 11+13
 Ave. No.
 Crandall
 Name of Owner Sisters Home
 1st Alphonse Church

Labor and Mat'l. Report June 14 19 56

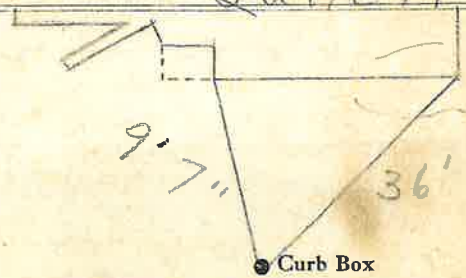

8" Main Elev. of Main at tap 5'
 Gate at • Gate at

• Curb Box