

LABOR AND MATERIALS


_____	Copper } Connection _____	\$ _____
_____	Lead } _____	\$ _____
_____	Curb } Cock _____	\$ _____
_____	Valve } _____ in.	\$ _____
_____	T.S. & V. } _____	\$ _____
_____	Service box { Short 3-1/2 x 4-1/2 }	\$ _____
_____	Old returned { Long 4-1/2 x 5-1/2 }	\$ _____
14'	Ft. 3/4 in. { Copper } Pipe at _____	\$ _____
_____	G.I. } _____	\$ _____
_____	C.I. } _____	\$ _____
_____	Nipples _____ in. at _____	\$ _____
_____	Bushings _____ to _____ in. at _____	\$ _____
_____	Red'g _____	\$ _____
_____	Inc'g _____	\$ _____
_____	Union _____ in. at _____	\$ _____
_____	Meter _____ in. at _____	\$ _____
_____	_____	\$ _____
_____	Compound Joints at _____	\$ _____
_____	Maintenance Foreman _____	\$ _____
_____	Hrs. Water Maint. Man - 1 at _____	\$ _____
_____	Hrs. Water Maint. Man - 2 at _____	\$ _____
_____	Hrs. Garage Foreman _____ at _____	\$ _____
_____	Hrs. Labor _____ at _____	\$ _____
_____	Hrs. Compressor at _____	\$ _____
_____	_____	\$ _____
_____	Trucking _____	\$ _____
_____	Pav't Patch _____	\$ _____
_____	_____	\$ _____
_____	_____	\$ _____
_____	_____	\$ _____
_____	_____	\$ _____

CROSSWAY


1
 St. PI. Ave. No. LOT 25

Name of Owner _____

Labor and Mat'l. Report 19 DEL. 30, 2003

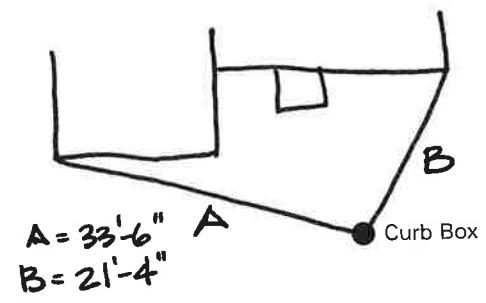

8" Main Elev. of Main at tap 5.0'
 Gate at ● Gate at ●

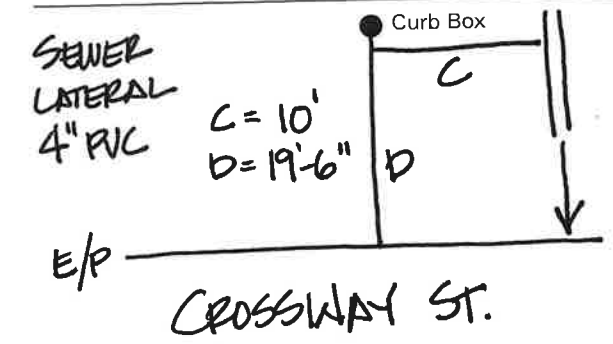

E/P CROSSWAY ST.