


# LABOR AND MATERIALS

_____	Copper	} Connection	_____	\$ _____
_____	Lead		_____	\$ _____
_____	Curb	} Cock Valve T.S. & V.	_____ in.	\$ _____
_____	Service box		{ Short 3-1/2 x 4-1/2 Long 4-1/2 x 5-1/2 }	_____
_____	Old returned	_____		\$ _____
_____	Ft. _____ in.	{ Copper G.I. C.I. }	Pipe at _____	\$ _____
_____	Nipples _____ in.		at _____	\$ _____
_____	Bushings _____ to _____ in.	at _____	\$ _____	
_____	Red'g			
_____	Inc'g			
_____	Union _____ in.	at _____	\$ _____	
_____	Meter _____ in.	at _____	\$ _____	
_____			\$ _____	
_____	Compound Joints at _____		\$ _____	
_____	Maintenance Foreman _____		\$ _____	
_____	Hrs. Water Maint. Man - 1 at _____		\$ _____	
_____	Hrs. Water Maint. Man - 2 at _____		\$ _____	
_____	Hrs. Garage Foreman _____ at _____		\$ _____	
_____	Hrs. Labor _____ at _____		\$ _____	
_____	Hrs. Compressor at _____		\$ _____	
_____			\$ _____	
_____	Trucking _____		\$ _____	
_____	Pav't Patch _____		\$ _____	
_____			\$ _____	
_____			\$ _____	
_____			\$ _____	
_____			\$ _____	

CROSSWAY St. Pl. Ave. No. 3  
Name of Owner \_\_\_\_\_

Labor and Mat'l. Report ~~40~~ 2015

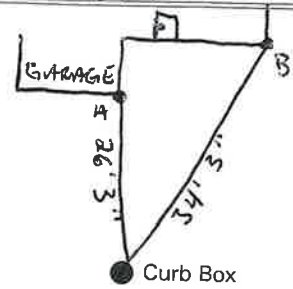

27' to Main Elev. of Main at tap \_\_\_\_\_  
Gate at ● Gate at ●

● Curb Box  
\* CLEAN OUT  
3 FT FROM SIDE "B" OF HOUSE

