

LABOR AND MATERIALS

Copper	} Connection		\$
Lead			
1 GATE Curb	} Cook Valve T.S. & V. } 4" in.		\$
1 Service box		} Short 3 1/2 x 4 1/2 } GATE BOX	
Old returned			Long 4 1/2 x 5 1/2
16 Ft. 4" in.	} Copper } Pipe at		\$
		} C.I.	
Nipples	in. at		\$
Bushings	to in. at		\$
Red'g } Inc'g }	} Coupl'gs to in. at		\$
Union		in. at	
Meter	in. at		\$
			\$
Compound Joints	at		\$
Maintenance Foreman			\$
Hrs. Water Maint. Man-1	at		\$
Hrs. Water Maint. Man-2	at		\$
Hrs. Garage Foreman	at		\$
Hrs. Labor-	at		\$
Hrs. Compressor	at		\$
			\$
Trucking			\$
Pav't Patch			\$
			\$
			\$
			\$
			\$

SETTING HYD.

CURRAN LANE

St.


Pl.

Ave. No.

Name of Owner

Labor and Mat'l. Report

JUNE 26 1926

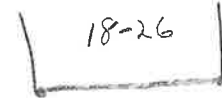

18' 4" 25' 10"

● Curb Box

4" Main

Elev. of Main at tap

4'

Gate at ●

● Gate at

● Curb Box