

LABOR AND MATERIALS

1	Copper Lead	Connection	3/4		\$ 1.35	
1	Curb	Cock Valve T. S. & V.	3/4 in.		\$ 1.88	
1	Service Box	Old returned	Short 3 1/2 x 4 1/2 Long 4 1/2 x 5 1/2 Buff. or Rdway		\$ 1.82	
27						
23	1 1/4 Ft.			3/4 in.		
				Copper Galv Iron Cast Iron	Pipe at 20 \$ 4.60	
	Nipples	in. at			\$	
	Bushings	to in. at			\$	
	Red'g Inc'g	Couplings to in. at			\$	
	Union	in. at			\$	
	Meter	in. at			\$	
	Lead Joints	at			\$	
	Leadite Joints	at			\$	
	Hrs. Foreman	at			\$	
10	Hrs. Chauffeur	at	6834		\$ 6.88	
	Hrs. Tapper	at			\$	
10	Hrs. Labor	at	55		\$ 5.50	
	Hrs. Labor	at			\$	
	Hrs. Compressor	at			\$	
	Compensation Ins.				\$ 38	
	Trucking				\$ 1-	
	Builders Use of Water	Patch			\$ 5.00	
	<i>Tapyk Wursinski</i>				\$	
					\$	
					\$	
					\$	
					\$	
					\$ 28.41	


§ 2 1942

St. _____
Pt. _____
Ave. No. 7

Darwin

Name of Owner
Quitterfield

Labor and Mat'l. Report *July 20 1942*

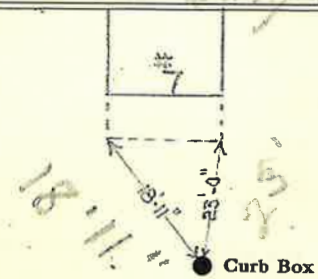

Main

Elev. of Main at tap 5 1/2

Gate at ● Gate at ●

TAX ID # 309.7-9-6

● Curb Box