



Labor and Materials

1	Copper	Connection	$\frac{3}{4}$	\$ 1.25
1	Lead			
4	Curb	Cock Valve T.S.&V.	in	\$ 1.70
1	Service Box	Short $3\frac{1}{2} \times 4\frac{1}{2}$		\$ 1.37
30	Old returned	Long $3\frac{1}{2} \times 4\frac{1}{2}$ Bull or Bldwy		
30	Ft. $\frac{3}{4}$ in.	Copper Galv. Iron Cast Iron	Pipe at 10 1/2	\$ 3.92
	Nipples	in. at		\$
	Bushings	to in. at		\$
	Red'g Inc'g	Couplings	to in. at	\$
	Union	in. at		\$
	Meter	in. at		\$
	Lbs. Br. Stone	at		\$
	Lbs. Sand	at		\$
	Bags Cement	at		\$
	Paving Brick	Mack Red Asphalt	at	\$
	Lead Joints	at		\$
	Leadite Joints	at		\$
3	Hrs. Foreman		6 1/2	\$ 1.88
2	Hrs. Common Labor		50	\$ 1-
16	Hrs. Common Labor		45	\$ 7.20
	Hrs. Mason	at		\$
	Hrs. Masons Helper	at		\$
	Hrs. Compressor	at		\$
	Compensation Ins			\$.38
	Trucking			\$ 1-
	Builders Use of Water	Patch		\$ 5-
Total				\$ 24.62

1935-77

Labor and Material Report

July 11, 1935
13 Darwin Ave.

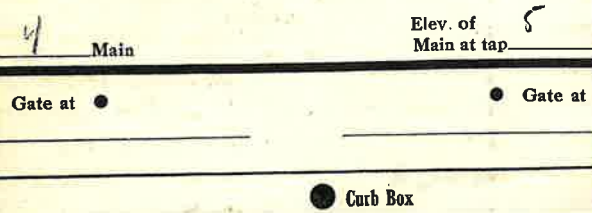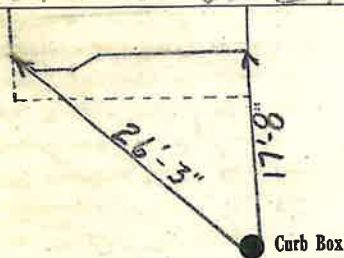

old tap disconnected.

THH