


LABOR AND MATERIALS

1	Copper	} Connection	3/4	_____	\$ _____
	Lead				
1	Curb	} Cock Valve T.S. & V.	} 3/4 in.	_____	\$ _____
1	Service box				
	Old returned				
			{ Short 3 1/2 x 4 1/2 Long 4 1/2 x 5 1/2 }	_____	\$ _____
24	Ft.	} Copper Gal. Gal.	} 3/4 in.	_____	\$ _____
	Nipples	_____	in. at _____	\$ _____	
	Bushings	_____	to _____ in. at _____	\$ _____	
	Red'g	} Coupl'gs	} _____	to _____ in. at _____	\$ _____
	Inc'g				
	Union	_____	in. at _____	\$ _____	
	Meter	_____	in. at _____	\$ _____	
		_____		\$ _____	
	Compound Joints	_____	at _____	\$ _____	
	Maintenance Foreman	_____		\$ _____	
	Hrs. Water Maint. Man-1	_____	at _____	\$ _____	
	Hrs. Water Maint. Man-2	_____	at _____	\$ _____	
	Hrs. Garage Foreman	_____	at _____	\$ _____	
	Hrs. Labor	_____	at _____	\$ _____	
	Hrs. Compressor	_____	at _____	\$ _____	
		_____		\$ _____	
	Trucking	_____		\$ _____	
	Pav't Patch	_____		\$ _____	
		_____		\$ _____	
		_____		\$ _____	
		_____		\$ _____	
		_____		\$ _____	

St. 11
 Ave. No. 11
 DIVISION

Name of Owner _____
 TAX ID # 309.27-3-5

Labor and Mat'l. Report MAY 24 1932

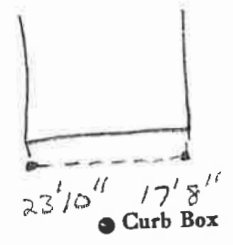

4" Main Elev. of Main at tap 5 1/2'
 Gate at • Gate at •

• Curb Box
 OLD TAP SHUT OFF AT MAIN