

LABOR AND MATERIALS


1	Copper	{ Connection	3/4"	\$	2.29
	Lead				
1	Curb	{ Cock Valve F.S. & V. }	3/4 in.	\$	2.70
1	Service box	{ Short 3 1/2 x 4 1/2 }		\$	4.25
	Old returned	{ Long 4 1/2 x 5 1/2 }			
		{ Buff or Rdway }			
14	Ft.	{ Copper G.I. G.I. }	3/4 in. Pipe at 35	\$	4.90
	Nipples	in. at		\$	
1	Bushings	3/4 to 1/2 in. at G.I.		\$	
	Red'g	{ Coupl'gs to in. at		\$	
	Ine'g				
	Union	in. at		\$	
	Meter	in. at		\$	
	Lead Joints at			\$	
	Compound Joints at			\$	1.12
1	Hrs. Water Maint. Man-1	at 1.12		\$	1.12
1	Hrs. Water Maint. Man-2	at 1.02		\$	1.02
10	Hrs. Labor	at 91		\$	9.10
	Hrs. Labor	at		\$	
	Hrs. Compressor at			\$	
	Compensation Ins. at \$	per C.		\$.25
	Trucking			\$	1.00
	Pav't Patch	B.P.		\$	
	Tap by Warsinski			\$	
				\$	
				\$	
	O'head			\$	
				\$	26.63

177-1150 Before Paving

Division _____ St. Pt. Ave. No. 20

Name of Owner
Catherine Dean

Labor and Mat'l. Report Aug 22 19 50

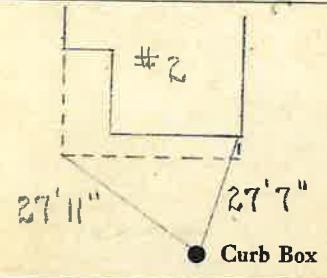

4" Main Elev. of Main at tap 5'
Gate at ● Gate at ●

● Curb Box