

LABOR AND MATERIALS

1	Copper	Connection	3/4	\$	2.29
1	Lead				
1	Curb	Cock Valve	1" Reused same	\$	
		F.S. & V.			
1	Service box	Short 3 1/2 x 4 1/2		\$	4.25
	Old returned	Long 4 1/2 x 5 1/2			
		Buff or Rdway		\$	
20	Ft. 3/4 in.	Copper	Pipe at 35	\$	7.00
		G.I.			
		C.I.			
	Nipples	in. at		\$	
1	Bushings	1" to 3/4" in.	at 55	\$	
	Red'g	Coupl'gs	to in. at	\$	
	Inc'g				
1	Union	3/4 in. at	Cu to Fe Fitting	\$	
	Meter	in. at		\$	
	Lead Joints	at		\$	17.49
	Compound Joints	at		\$	
4	Hrs. Water Maint. Man-1	at		\$	4.48
2	Hrs. Water Maint. Man-2	at		\$	2.04
	Hrs. Labor	at		\$	
12	Hrs. Labor	at		\$	10.92
	Hrs. Compressor	at		\$	
	Compensation Ins. at \$	per C.		\$	1.39
	Trucking			\$	1.39
	Pav't Patch	B.P.		\$	
	Tap by Warsinski			\$	
	O'head			\$	
				\$	32.31

122-1950

Before Taving

Division


St. Pt. Ave. No. 5

Name of Owner

Doris Anna Silvernell

Labor and Mat'l. Report

Aug 22 1950

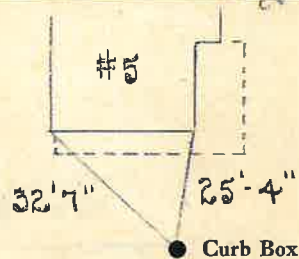

4" Main

Elev. of Main at tap 5'

Gate at ●

● Gate at

● Curb Box