

LABOR AND MATERIALS

1	Copper	{ Connection	3/4"		\$ 2.29
	Lead				
1	Curb	{ Cock Valve	3/4 in.		\$ 2.70
		T.S. & V.			
1	Service box	{ Short 3 1/2 x 4 1/2			
	Old returned	Long 4 1/2 x 5 1/2			\$ 4.25
		Buff or Rdway			
21	Ft.	{ Copper	3/4 in.	Pipe at 35	\$ 7.35
		G.I.			
	Nipples	in. at			\$
1	Bushings	3/4 to 1/2 in. at G.I.			\$
	Red'g	{ Coupl'gs	to	in. at	\$
	Inc'g				
	Union	in. at			\$
	Meter	in. at			\$
	Lead Joints at				\$ 17.44
	Compound Joints at				\$
4	Hrs. Water Maint. Man-1	at 112			\$ 4.48
2	Hrs. Water Maint. Man-2	at			\$ 2.04
12	Hrs. Labor	at 91			\$ 10.92
	Hrs. Labor	at			\$
	Hrs. Compressor at				\$
	Compensation Ins. at \$	per C.			\$ 39
	Trucking				\$ 1.00
	Pav't Patch	B.P.			\$
	Tap by Warsinski				\$
					\$
					\$
	O'head				\$
					\$ 25.47

184-1950

Before Filing

Division


St. PT
Ave No. 9

Name of Owner

Mrs. Martha Stevenson

Labor and Mat'l. Report

Aug 22 19 50

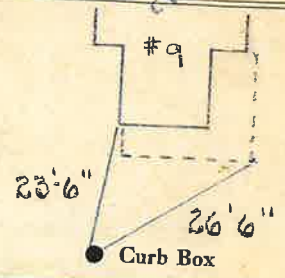

4" Main

Elev. of Main at tap 5'

Gate at ●

● Gate at

● Curb Box