


LABOR AND MATERIALS

1	Copper Lead	Connection	$\frac{1}{2}$ "	\$
1	Curb	Cock Valve T.S. & V.	$\frac{3}{4}$ " in.	\$
1	Service box Old returned	Short $3\frac{1}{2}$ x $4\frac{1}{2}$ Long $4\frac{1}{2}$ x $5\frac{1}{2}$		\$
13	Ft.	$\frac{3}{4}$ " in. Copper G. I. Pipe		\$
	Nipples	in. at		\$
	Bushings	to in. at		\$
	Red'g Inc'g	Coupl'gs to in. at		\$
	Union	in. at		\$
	Meter	in. at		\$
	Compound Joints	at		\$
	Maintenance Foreman			\$
	Hrs. Water Maint. Man-1	at		\$
	Hrs. Water Maint. Man-2	at		\$
	Hrs. Garage Foreman	at		\$
	Hrs. Labor	at		\$
	Hrs. Compressor	at		\$
	Trucking			\$
	Pav't Patch			\$
				\$
				\$
Dix Ave. No. 17
 Name of Owner

Labor and Mat'l. Report MAY 14 1923

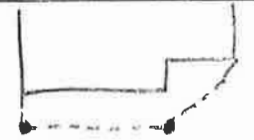

24 3/4" 27 1/2"

● Curb Box

4" Main Elev. of Main at tap 5'
 Gate at ● Gate at

TAX ID #303.13-16-7

● Curb Box