

LABOR AND MATERIALS

1	Copper Lead	} Connection	3/4		\$ 1.35
1	Curb	{ Cock Valve F.S. & V.	3/4	in.	\$ 1.80
1	Service Box Old returned	{ Short 3 1/2 x 4 1/2 Long 4 3/4 x 5 1/2 Buffer Rdway			\$ 1.70
14	Ft.	3/4 in.	{ Copper Galv Iron Cast Iron	Pipe at 1/8	\$ 2.52
	Nipples	in. at			
	Bushings	to in. at			
	Red'g Inc'g	} Couplings	to in. at		
	Union	in. at			
	Meter	in. at			
	Lead Joints				
	Leadite Joints				
	Hrs. Foreman				
1	Hrs. Chauffeur	at	6 1/2 hr		\$ 63
2 1/2	Hrs. Tapper	at			\$ 1.56
9 1/2	Hrs. Labor	at	4 1/2		\$ 4.28
	Hrs. Labor	at			
	Hrs. Compressor	at			
	Compensation Ins.				
	Trucking				
	Builders Use of Water	Before Saving			
	<i>Supply Hesse</i>				
					\$ 15.04

1 3 2 1941

Dix


~~St.~~
~~Pl.~~
Ave. No. 19

Name of Owner

John F Nash

Labor and Mat'l. Report

Oct 14 1941

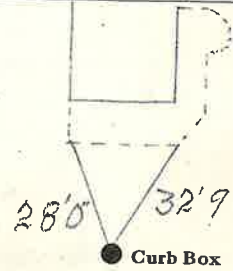

4" Main

Elev. of
Main at tap 5'

Gate at ●

● Gate at

● Curb Box