


LABOR AND MATERIALS

| | | | | | |
|----|-------------------------|----------------------|---|-------------------|-------|
| 1 | Copper | Lead | Connection | $\frac{3}{4}$ | \$ |
| 1 | Curb | Cock Valve T.S. & V. | | $\frac{3}{4}$ in. | \$ |
| 1 | Service box | Old returned | Short $3\frac{1}{2} \times 4\frac{1}{2}$ Long $4\frac{1}{2} \times 5\frac{1}{2}$ | | \$ |
| 30 | Ft. | $\frac{3}{4}$ in. | Copper Pipe | at | \$ |
| | Nipples | in. | at | | \$ |
| | Bushings | to | in. | at | \$ |
| 1 | Red'g Lead'g | Coupl'gs | $\frac{3}{4}$ | to in. | at \$ |
| | Union | in. | at | | \$ |
| | Meter | in. | at | | \$ |
| | Compound Joints | at | | | \$ |
| | Maintenance Foreman | | | | \$ |
| | Hrs. Water Maint. Man—1 | at | | | \$ |
| | Hrs. Water Maint. Man—2 | at | | | \$ |
| | Hrs. Garage Foreman | at | | | \$ |
| | Hrs. Labor— | at | | | \$ |
| | Hrs. Compressor | at | | | \$ |
| | Trucking | | | | \$ |
| | Pav't Patch | | | | \$ |
| | | | | | \$ |
| | | | | | \$ |
St. DIX
Ave. No. 20

Name of Owner _____

Labor and Mat'l. Report MAY 28 1925

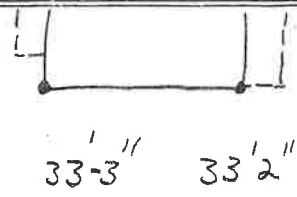

● Curb Box

4" Main Elev. of Main at tap 5'

Gate at ● ● Gate at

● Curb Box