

LABOR AND MATERIALS

1	Copper	} Connection	3/4		\$ 1.35
1	Curb	{ Cock Valve	3/4	in.	\$ 1.80
		{ T.S. & V.			
1	Service Box	{	Short	3 1/2 x 4 1/2	\$ 1.70
	Old returned		Long	4 1/2 x 5 1/2	
			Buffer Rdway		
12	Ft.	3/4	in.	{ Copper Galv Iron Cast Iron	Pipe at 18 \$ 2.16
	Nipples		in. at		\$
	Bushings		to in. at		\$
	Red'g Inc'g	{	Couplings	to in. at	\$
	Union		in. at		\$
	Meter		in. at		\$
	Lead Joints at				\$
	Leadite Joints at				\$
	Hrs. Foreman at				\$
1	Hrs. Chauffeur at		6 1/2		\$.63
2 1/2	Hrs. Tapper at				\$ 1.56
9 1/4	Hrs. Labor at		45		\$ 4.25
	Hrs. Labor at				\$
	Hrs. Compressor at				\$
	Compensation Ins.				\$ 20
	Trucking				\$ 1.-
	Builders Use of Water				\$
	<i>Taply Hessel</i>				\$
					\$
					\$
					\$
					\$
					\$ 14.68


130 1941

-St-
-Pl-
Ave. No. 25

Dix Cer Cherry

Name of Owner
Nora Herlihy *Lot tap*

Labor and Mat'l. Report *Oct 10* 1941

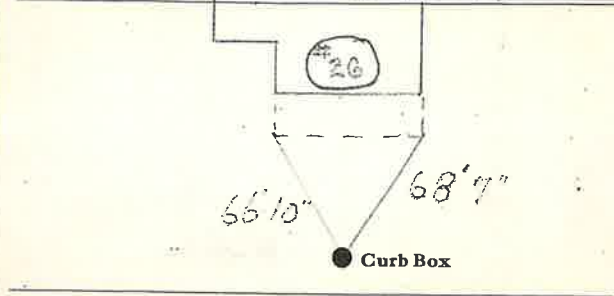

6'' Main Elev. of Main at tap *5'*

Gate at ● ● Gate at

● Curb Box