


LABOR AND MATERIALS

| | | | | |
|----|----------------------------|--|-------------------|----|
| 1 | Copper | Connection | $\frac{3}{4}$ | \$ |
| 1 | Lead | | | |
| 1 | Curb | Cock Valve | $\frac{3}{4}$ in. | \$ |
| | | T.S. & V. | | |
| 1 | Service box | Short $3\frac{1}{2} \times 4\frac{1}{2}$ | | |
| | Old returned | Long $4\frac{1}{2} \times 5\frac{1}{2}$ | | \$ |
| 16 | Ft. | Copper | | |
| | $\frac{3}{4}$ in. | Pipe at | | \$ |
| | | | | |
| | Nipples | in. at | | \$ |
| | Bushings | to in. at | | \$ |
| | Red'g | | | |
| | Inc'g | Coupl'gs to in. at | | \$ |
| | Union | in. at | | \$ |
| | Meter | in. at | | \$ |
| | | | | \$ |
| | Compound Joints at | | | \$ |
| | Maintenance Foreman | | | \$ |
| | Hrs. Water Maint. Man-1 at | | | \$ |
| | Hrs. Water Maint. Man-2 at | | | \$ |
| | Hrs. Garage Foreman at | | | \$ |
| | Hrs. Labor at | | | \$ |
| | Hrs. Compressor at | | | \$ |
| | | | | \$ |
| | Trucking | | | \$ |
| | Pav't Patch | | | \$ |
| | | | | \$ |
| | | | | \$ |
| | | | | \$ |
| | | | | \$ |

DIX Ave. No. 35
 Name of Owner

Labor and Mat'l. Report SEPT. 18 1933

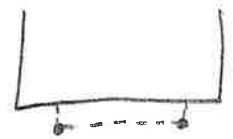

32'6" 19'

● Curb Box

6" Main Elev. of Main at tap 4 1/2'
 Gate at ● Gate at

● Curb Box

OLD TAP SHUT OFF AT MAIN
 REVERSE CURB STOP - IS ON
 IN "OFF POSITION"