

LABOR AND MATERIALS

| | | | | | |
|-------|-----------------------------|---|---------------|-----------|---------------------|
| 1 | Copper Lead | } Connection | $\frac{3}{4}$ | | \$ 1.35 |
| 1 | Curb | } Cock Valve T. S. & V. | $\frac{3}{4}$ | in. | \$ 1.80 |
| 1 | Service Box Old returned | } Short $3\frac{1}{2} \times 4\frac{1}{2}$ Long $4\frac{1}{2} \times 5\frac{1}{2}$ Buffer Rdway | | | \$ 1.70 |
| 12 | Ft. | } Copper Galv Iron Cast Iron | $\frac{3}{4}$ | in. | Pipe at 1.8 \$ 2.34 |
| | Nipples | | | in. at | \$ |
| | Bushings | | | to in. at | \$ |
| | Red'g Inc'g | } Couplings | | to in. at | \$ |
| | Union | | | in. at | \$ |
| | Meter | | | in. at | \$ |
| | Lead Joints | | | | \$ |
| | Leadite Joints | | | | \$ |
| | Hrs. Foreman | | | | \$ |
| 1 | Hrs. Chauffeur | | 62 1/2 | | \$ 63 |
| 2 1/2 | Hrs. Tapper | | 9 | | \$ 1.56 |
| 9 1/2 | Hrs. Labor | | 45 | | \$ 4.29 |
| | Hrs. Labor | | | | \$ |
| | Hrs. Compressor | | | | \$ |
| | Compensation Ins. | | | | \$ 20 |
| | Trucking | | | | \$ 1- |
| | Builders Use of Water | Before Permit | | | \$ |
| | <i>Truck by Hass-ox</i> | | | | \$ |
| | | | | | \$ |
| | | | | | \$ |
| | | | | | \$ |
| | | | | | \$ |
| | | | | | \$ 14.86 |

1 2 8 1941

~~St~~
~~Pl~~

Ave. No. 9

Dix


Name of Owner

John Angelo

Labor and Mat'l. Report

Oct 16

19 41

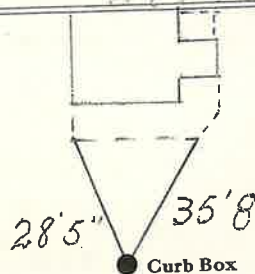

● Curb Box

4 1/2

Main

Elev. of
Main at tap. 5'

Gate at ●

● Gate at

● Curb Box