


LABOR AND MATERIALS

1	Copper Lead	} Connection $\frac{3}{4}$	\$
	Curb		\$
		} $\frac{3}{4}$ in.	\$
			\$
1	Service box Old returned.	{ Short $3\frac{1}{2} \times 4\frac{1}{2}$ Long $4\frac{1}{2} \times 5\frac{1}{2}$	\$
			\$
14	Ft. $\frac{3}{4}$ in.	{ Copper G.I. G.I.	} Pipe at \$
	Nipples	in. at	\$
	Bushings	to in. at	\$
	Red'g Inc'g	} Coupl'gs to in. at	\$
	Union		
	Meter	in. at	\$
			\$
	Compound Joints	at	\$
	Maintenance Foreman		\$
	Hrs. Water Maint. Man-1	at	\$
	Hrs. Water Maint. Man-2	at	\$
	Hrs. Garage Foreman	at	\$
	Hrs. Labor	at	\$
	Hrs. Compressor	at	\$
			\$
	Trucking		\$
	Pav't Patch		\$
			\$
			\$
			\$
			\$

DIX Ave. No. 53-55

Name of Owner _____
 Labor and Mat'l. Report OCT. 21 1927

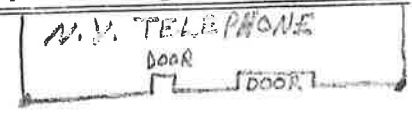

31' 61' 11"

● Curb Box

6" Main Elev. of Main at tap 5'

Gate at ● ● Gate at

● Curb Box

NEW TAP