

Labor and Materials

1. Copper } Connection 3/4"	\$ 1.33
1. Lead }	
1. Curb { Cock Valve } 3/4" in	\$ 1.58
{ T.S.&V. }	
1. Service Box { Short 3 1/2 x 4 1/2 }	\$ 1.36
Old returned { Long 4 1/2 x 5 1/2 }	
{ Buff. or Rdwax }	
33 Ft. 3/4 in. { Copper } Pipe at	\$ 3.14
{ Galv. Iron }	
{ Cast Iron }	
Nipples in. at	\$
Bushings to in. at	\$
Red'g } Couplings to in. at	\$
Inc'g }	
Union in. at	\$
Meter in. at	\$
Lbs. Br. Stone at	\$
Lbs. Sand at	\$
Bags Cement at	\$
Paving Brick { Mack } at	\$
{ Red }	
{ Asphalt }	
Lead Joints at	\$
Leadite Joints at	\$
17 Hrs. Foreman at	\$ 7.50
1 Hrs. Common Labor at	\$ 3.15
Hrs. Common Labor at	\$
Hrs. Mason at	\$
Hrs. Masons Helper at	\$
Hrs. Compressor at	\$
Compensation Ins	\$ 33
Trucking	\$ 1.00
Builders Use of Water <i>Satch</i>	\$ 5.00
Total \$ 24.39	


33-19

Labor and Material Report

May 11

1923

3/4" tap at 74 Dix Ave

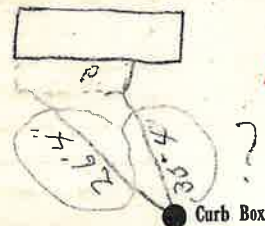

RAZED

12" EXT. 1953

6" Main

Elev. of Main at tap 4.11

Gate at ●

● Gate at

● Curb Box

Old Tap shut off

OK *[Signature]*

House To Be Razed