


Labor and Materials

1	Copper	Connection.	3/4	\$	3.20
1	Lead			\$	
1	Curb	{ Cock Valve T. S. & V. }	3 1/4" in.	\$	1.00
1	Service Box	{ Short 3 1/2 x 4 1/2 Long 4 1/2 x 5 1/2 Buff. or Rdway }		\$	1.20
30	Pipe	{ Copper Galv. Iron Cast Iron }	3/4" in.	\$	6.00
	Nipples		in. at	\$	
1	Bushings		2 1/2" to 2" in. at	\$.08
1	Red 1/2 in. Pipe	Couplings.	Broads in. at	\$.15
	Union		in. at	\$	
	Meter		in. at	\$	
	Lbs. Br. Stone	at		\$	
	Lbs. Sand	at		\$	
	Bags Cement	at		\$	
	Paving Brick	{ Mack Red Asphalt }	at	\$	
	Lead Joints	at		\$	
	Leadite Joints	at		\$	
7	Hrs. Foreman	at	6 2/5	\$	2.50
2	Hrs. Common Labor	at	5.0	\$	1.00
5	Hrs. Common Labor	at	10.8	\$	3.24
	Hrs. Mason	at		\$	
	Hrs. Mason's Helper	at		\$	
	Hrs. Compressor	at		\$	
	Compensation Ins.			\$.19
	Trucking			\$	1.00
	Builders' Use of Water			\$	
				Total \$	20.27

26-165
Labor and Material Report Oct 28 1926

3/4 tap at 60 Dix Ave

RAZED

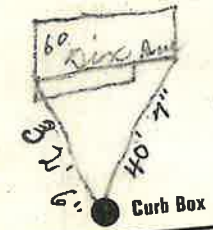

12" EXT. 1953

Main Gate at ● Elev. of Main at tap 4.11 Gate at ●

● Curb Box

House To Be RAZED

Iron Clad Portland Cement
VELO HIGH-EARLY - IRON CLAD MASONRY CEMENT



mes for 76 Dix Ave

GLENS FALLS, N. Y.
Area Code 518
RX 2-1137

THE GLENS FALLS PORTLAND CEMENT CO.
A DIVISION OF THE PLINKOTE COMPANY
GLENS FALLS, N. Y.

BOSTON, MASS.
Area Code 617
11-2-4634