

LABOR AND MATERIALS

1	Copper	{ Connection	3/4	\$	2.29
	Lead				
1	Curb	{ Cock Valve	3/4 in.	\$	2.70
		{ T.S. & V.			
1	Service box	{ Short 3 1/2 x 4 1/2		\$	4.25
	Old returned	{ Long 4 1/2 x 5 1/2			
		{ Buff or Redway			
67	Ft.	{ Copper	Pipe at 35	\$	23.45
	3/4 in.	{ Gate			
		{ Gate			
	Nipples	in. at		\$	
	Bushings	to in. at		\$	
1	Red'g Inc'g	{ Coupl'gs 3/4 to 1/2	in. at	\$	
		{ copper			
	Union	in. at		\$	
	Meter	in. at		\$	
	Lead Joints at			\$	
	Compound Joints at			\$	
7	Hrs. Water Maint. Man-1	at 1.12		\$	7.84
14	Hrs. Water Maint. Man-2	at 1.02		\$	14.28
	Hrs. Labor	at		\$	
17	Hrs. Labor	at 91		\$	15.47
7	Hrs. Compressor at	1.20		\$	8.40
	Compensation Ins. at \$	per C.		\$	84
	Trucking			\$	1.59
	Pav't Patch			\$	18.90
	Tap by Warrinslee			\$	
				\$	
				\$	
	O'head			\$	

This Tap is from
End of 6" Pipe on Prospect
St.

10-1950

Dix

Ave. No. 92-94


Name of Owner

Sillero

Labor and Mat'l. Report

May 9

19 50

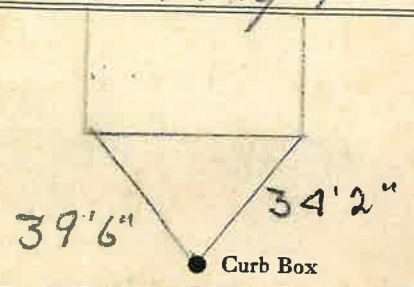

6" Main

Elev. of Main at tap 4'

Gate at ●

● Gate at

● Curb Box

This Tap on South
side of Prospect St.
Gate at Dix Ave.