


LABOR AND MATERIALS

1 Copper } Connection $\frac{3}{4}$ \$
~~Lead~~
 1 Curb { Cock Valve } $\frac{3}{4}$ in. \$
 { T. S. & V. }
 1 Service Box { Short $3\frac{1}{2} \times 4\frac{1}{2}$ } \$
 Old returned { Long $4\frac{1}{2} \times 5\frac{1}{2}$ } \$
 { Buff. or Rdway }
 30 Ft. $\frac{3}{4}$ in. { Copper } Pipe at \$
 { Galv Iron }
 { Cast Iron }
 Nipples in. at \$
 Bushings to in. at \$
 Red'g } Couplings to in. at \$
 Inc'g }
 Union in. at \$
 Meter in. at \$
 Lead Joints at \$
 Leadite Joints at \$
 Hrs. Foreman at \$
 Hrs. Chauffeur at \$
 Hrs. Tapper at \$
 Hrs. Labor at \$
 Hrs. Labor at \$
 Hrs. Compressor at \$
 Compensation Ins. \$
 Trucking \$
 Builders Use of Water \$
 \$
 \$
St
 Pt. Dix
 Ave. No. 93

Name of Owner

Labor and Mat'l. Report Oct. 8 1925

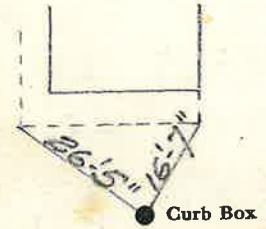

Top 07
 Main Prospect Elev. of Main at tap
 Gate at ● 1st. ● Gate at

● Curb Box

See also card
 for ~~77~~ Prospect St.
 95

LABOR AND MATERIALS

Copper } Connection _____ \$ _____
 Lead }
 Curb } Cock _____ in. _____ \$ _____
 Valve }
 T.S. & V. }
 Service box { Short 3-1/2 x 4-1/2 } _____ \$ _____
 Old returned { Long 4-1/2 x 5-1/2 }
 Ft. _____ in. { Copper } Pipe at _____ \$ _____
 { G.I. }
 { C.I. }
 Nipples _____ in. at _____ \$ _____
 Bushings _____ to _____ in. at _____ \$ _____
 Red'g _____
 Inc'g _____
 Union _____ in. at _____ \$ _____
 Meter _____ in. at _____ \$ _____
 _____ \$ _____
 Compound Joints at _____ \$ _____
 Maintenance Foreman _____ \$ _____
 Hrs. Water Maint. Man - 1 at _____ \$ _____
 Hrs. Water Maint. Man - 2 at _____ \$ _____
 Hrs. Garage Foreman _____ at _____ \$ _____
 Hrs. Labor _____ at _____ \$ _____
 Hrs. Compressor at _____ \$ _____
 _____ \$ _____
 Trucking _____ \$ _____
 Pav't Patch _____ \$ _____
 _____ \$ _____
 _____ \$ _____
 _____ \$ _____
 _____ \$ _____

St. _____
Pl. _____
Ave. No. _____


Name of Owner _____

Labor and Mat'l. Report 19 10-31-12

● Curb Box

_____ Main Elev. of Main at tap _____

Gate at ● ● Gate at

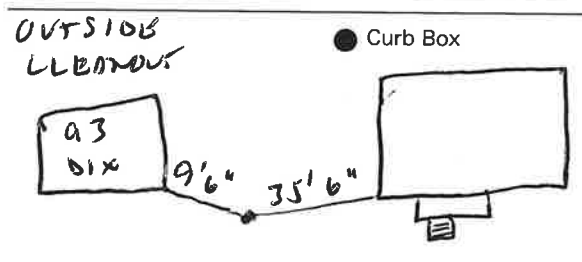

● Curb Box