

LABOR AND MATERIALS

1	Copper	Connection	3/4"	\$	2.76
1	Lead			\$	
1	Curb	Cock Valve	3/4" in.	\$	3.49
		T. S. & V.		\$	
1	Service box	Short 3/4 X 4 1/2	Cutoff	\$	4.94
	Old returned	Long 4 1/2 X 5 1/2	Buffer Rdway	\$	
9	Ft.	3/4 in.	Copper	Pipe at	38
			C.I.		
			C.I.		
	Nipples	in. at		\$	
	Bushings	to in. at		\$	
	Red'g			\$	
	Inc'g	Coupl'gs to in. at		\$	
	Union	in. at		\$	
	Meter	in. at		\$	
	Lead Joints	at		\$	
	Compound Joints	at		\$	
	Hrs. Water Maint. Man-1	at		\$	
8	Hrs. Water Maint. Man-2	at 1.24		\$	9.92
16	Hrs. Labor-	at 1.13		\$	18.08
	Hrs. Labor-	at		\$	
	Hrs. Compressor	at		\$	
	Compensation Ins.	at \$4.407 per C.		\$	1.73
	Trucking			\$	1.00
	Pav't Patch			\$	
	Tap by Jiggard	7-13-53		\$	
	O'head			\$	
				\$	44.64

4464

57.52


Str  
Pl  
Ave. No. 95

Dix

Name of Owner

BARBER Chappa  
SHOP

Labor and Mat'l. Report July 13 19 53

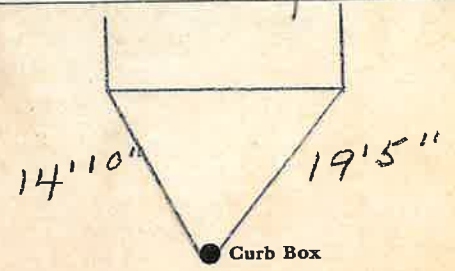

12" Main

Elev. of Main at tap 3 1/2'

Gate at ●

● Gate at

● Curb Box