


LABOR AND MATERIALS

Copper } Connection	_____	\$ _____
Lead } _____	_____	\$ _____
Curb } Cock	_____ in.	\$ _____
} Valve	_____	\$ _____
} T. S. & V.	_____	\$ _____
Service box } Short 3½ x 4½	_____	\$ _____
Old returned } Long 4½ x 5½	_____	\$ _____
Ft. / in. } Copper	_____	\$ _____
} G. I.	_____	\$ _____
} C. I.	_____	\$ _____
Nipples _____ in. at _____	_____	\$ _____
Bushings _____ to _____ in. at _____	_____	\$ _____
Red'g } Coupl'gs _____ to _____ in. at _____	_____	\$ _____
Inc'g } _____	_____	\$ _____
Union _____ in. at _____	_____	\$ _____
Meter _____ in. at _____	_____	\$ _____
_____	_____	\$ _____
Compound Joints at _____	_____	\$ _____
Maintenance Foreman _____	_____	\$ _____
Hrs. Water Maint. Man—1 at _____	_____	\$ _____
Hrs. Water Maint. Man—2 at _____	_____	\$ _____
Hrs. Garage Foreman _____ at _____	_____	\$ _____
Hrs. Labor— _____ at _____	_____	\$ _____
Hrs. Compressor at _____	_____	\$ _____
_____	_____	\$ _____
Trucking _____	_____	\$ _____
Pav't Patch _____	_____	\$ _____
_____	_____	\$ _____
_____	_____	\$ _____
St. _____
 Pt. _____
 Ave. No. 100

Name of Owner
DIX
LA CASOIR

Labor and Mat'l. Report 19 94

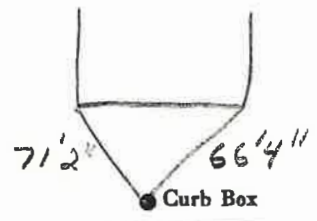

Main Elev. of
Main at tap _____

Gate at • • Gate at _____

TAX ID # 303.13-15-17

• Curb Box