

LABOR AND MATERIALS

Copper } Connection	_____	\$ _____	
Lead } _____			
Curb } Cock	} in. _____	\$ _____	
Valve			
T. S. & V.			
Service box } Short 3½ x 4½	} _____	\$ _____	
Old returned } Long 4½ x 5½			
Buff or Rdway			
33 30 Ft. 3/4 in. } Copper	} Pipe at _____	\$ _____	
			G.I.
			C.I.
Nipples _____ in. at _____		\$ _____	
Bushings _____ to _____ in. at _____		\$ _____	
Red'g } _____	} Coupl'gs. _____ to _____ in. at _____	\$ _____	
Inc'g			
Union _____ in. at _____		\$ _____	
Meter _____ in. at _____		\$ _____	
Lead Joints at _____		\$ _____	
Compound Joints at _____		\$ _____	
Maintenance Foreman _____		\$ _____	
Hrs. Water Maint. Man—1 at _____		\$ _____	
Hrs. Water Maint. Man—2 at _____		\$ _____	
Hrs. Garage Foreman _____ at _____		\$ _____	
Hrs. Labor— _____ at _____		\$ _____	
Hrs. Compressor at _____		\$ _____	
Compensation Ins. at \$ _____ per C _____		\$ _____	
Trucking _____		\$ _____	
Pav't Patch _____		\$ _____	
_____		\$ _____	
_____		\$ _____	
O'head _____		\$ _____	
_____		\$ _____	

Dix

St. _____
Pl. _____
Ave. No. 108

Name of Owner
A. George

Labor and Mat'l. Report 9-24 1986

● Curb Box


6" Main

Elev. of Main at top 4'4"

Gate at ● Gate at

TAX ID # 303.13-15-20

Siena

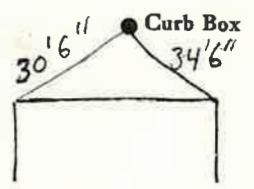

Dix