

LABOR AND MATERIALS

1 Copper } Connection ^{3/4} in. \$ _____
 -Lead }
 1 Curb } Cock } ^{3/4} in. \$ _____
 } Valve }
 } T.S. & V. }
 1 Service box } Short 3 1/2 x 4 1/2 }
 - Old returned } Long 4 1/2 x 5 1/2 } \$ _____
 } Buff or Rdway }
 11 Ft. ^{3/4} in. } { Copper } Pipe at \$ _____
 } { G.I. }
 } { C.I. }
 Nipples in. at \$ _____
 Bushings to in. at \$ _____
 Red'g }
 Inc'g } Coupl'gs to in. at \$ _____
 Union in. at \$ _____
 Meter in. at \$ _____
 Lead Joints at \$ _____
 Compound Joints at \$ _____
 Maintenance Foreman \$ _____
 Hrs. Water Maint. Man-1 at \$ _____
 Hrs. Water Maint. Man-2 at \$ _____
 Hrs. Garage Foreman at \$ _____
 Hrs. Labor at \$ _____
 Hrs. Compressor at \$ _____
 Compensation Ins. at \$ _____ per C \$ _____
 Trucking \$ _____
 Pav't Patch \$ _____
 Tap by Gifford + \$ _____
 Kelly 11-6-63. \$ _____
 O'head \$ _____
 \$ _____

-St-
 -Pl-
 Ave. No. 111


Dix

Name of Owner

Joseph Delsignore

Labor and Mat'l. Report

Nov. 6 1963

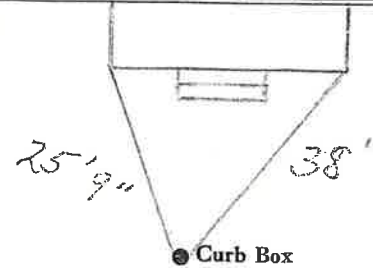

● Curb Box

C.I.
12" Main

Elev. of Main at tap 4 1/2"

Gate at ●

● Gate at

● Curb Box