


LABOR AND MATERIALS

Copper	} Connection	_____	\$
Lead		_____	\$
Curb	} Cock } Valve } T. S. & V.	_____ in.	\$
Service box		} Short 3½ x 4½ } Long 4½ x 5½	_____
Old returned			_____
34 Ft. $\frac{3}{4}$ in.	} Copper } C.I. } C.I.	Pipe at _____	\$
Nipples		_____ in. at _____	\$
Bushings	_____ to _____ in. at _____	\$	
Red'g Inc'g	} Coupl'gs	_____ to _____ in. at _____	\$
Union		_____ in. at _____	\$
Meter	_____ in. at _____	\$	
Compound Joints	_____ at _____	\$	
Maintenance Foreman	_____ at _____	\$	
Hrs. Water Maint. Man-1	_____ at _____	\$	
Hrs. Water Maint. Man-2	_____ at _____	\$	
Hrs. Garage Foreman	_____ at _____	\$	
Hrs. Labor-	_____ at _____	\$	
Hrs. Compressor	_____ at _____	\$	
Trucking	_____ at _____	\$	
Pav't Patch	_____ at _____	\$	
		\$	
		\$	
DIY
 Ave. No. 122

Name of Owner _____

Labor and Mat'l. Report APR. 27 1928

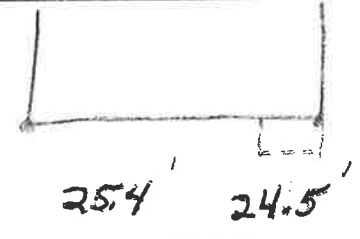

● Curb Box

12" Main Elev. of Main at tap _____
 Gate at ● ● Gate at

● Curb Box