


## LABOR AND MATERIALS

Copper	{	Connection	<i>None</i>	\$		
Lead						
1	{	Curb	in.	\$	<i>3.49</i>	
		Cock Valve				
		T. S. & V.				
<i>Sam.</i>	{	Service box	Short $3\frac{1}{2} \times 4\frac{1}{2}$	\$	<i>4.75</i>	
		Old returned	Long $4\frac{1}{2} \times 5\frac{1}{2}$			
			Buff or Rdway			
22	{	Ft. $\frac{3}{4}$ in.	Copper	Pipe at <i>35</i>	\$ <i>7.70</i>	
			C.I.			
1	{	Nipples	$\frac{3}{4}$ in. at <i>3" long</i>	\$	<i>1.23</i>	
1		Bushings	to $\frac{3}{8}$ in. at <i>Males</i>	\$	<i>53</i>	
		Red'g				
		Inc'g	Coupl'gs to in. at	\$		
		Union	in. at	\$		
		Meter	in. at	\$		
		Lead Joints	at	\$		
		Compound Joints	at	\$		
		Hrs. Water Maint. Man-1	at	\$		
<i>21</i>		Hrs. Water Maint. Man-2	at <i>12.4</i>	\$	<i>26.04</i>	
<i>5.1</i>		Hrs. Labor	at <i>1.3</i>	\$	<i>57.63</i>	
		Hrs. Labor	at	\$		
		Hrs. Compressor	at	\$		
		Compensation Ins.	at \$ <i>3.106</i> per C	\$	<i>3.10</i>	
		Trucking		\$	<i>1.00</i>	
		Pav't Patch	<i>no patch</i>	\$		
		Tap by <i>Giffard</i>		\$		
			<i>8-22-52</i>	\$		
		O'head		\$		
					<i>\$104.37</i>	

St. *Dix*  
Pr. *132*  
Ave. No. *132*

Name of Owner *Paris*

Labor and Mat'l. Report *Aug 22 1952*

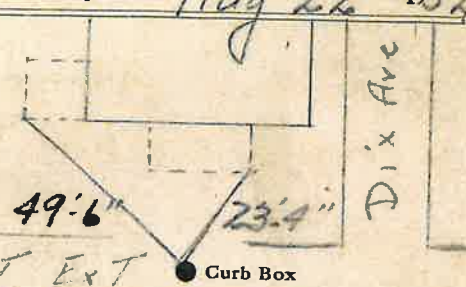

*1" COPPER*  
Main

Elev. of Main at tap *3 1/2'*

Gate at ● Gate at ●

● Curb Box

*This tap on Platt St. EXT.*

OTHER TIES ON APPLICATION CARD