


LABOR AND MATERIALS

1	Copper	} Connection	$\frac{3}{4}$	\$	_____	
	Lead					
1	Curb	} Cock Valve	$\frac{3}{4}$ in.	\$	_____	
1	Service box	} Short $3\frac{1}{2} \times 4\frac{1}{2}$	}	\$	_____	
	Old returned			Long $4\frac{1}{2} \times 5\frac{1}{2}$		
36	Ft.	} Copper	in.	} Pipe at	\$	_____
					C.P.	
		C.P.				
	Nipples	in.	at	\$	_____	
	Bushings	to	in.	at	\$	_____
	Red'g	} Coupl'gs	to	in.	at	\$
	Inc'g					
	Union	in.	at	\$	_____	
	Meter	in.	at	\$	_____	
				\$	_____	
	Compound Joints	at		\$	_____	
	Maintenance Foreman			\$	_____	
	Hrs. Water Maint. Man—1	at		\$	_____	
	Hrs. Water Maint. Man—2	at		\$	_____	
	Hrs. Garage Foreman	at		\$	_____	
	Hrs. Labor	at		\$	_____	
	Hrs. Compressor	at		\$	_____	
				\$	_____	
	Trucking			\$	_____	
	Pav't Patch			\$	_____	
				\$	_____	
				\$	_____	
DEX Ave. No. 186
 Name of Owner _____

Labor and Mat'l. Report JUNE 11 1934

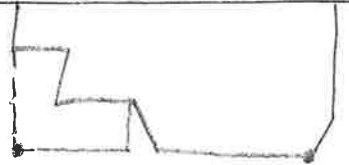

37 1/4" 34 1/2"
 ● Curb Box

6" Main Elev. of Main at tap 4"
 Gate at ● Gate at

● Curb Box
 NEW TAP OLD HOUSE
 OLD TAP TO BE DUG UP
 NOTE - ON in OFF POSITION
 SHUT OFF TO THE LEFT


LABOR AND MATERIALS

_____	Copper } Connection	_____	\$
_____	Lead } _____		
_____	Curb } Cock	_____ in.	\$
_____	Valve } _____		
_____	T.S. & V. } _____		
_____	Service box { Short 3-1/2 x 4-1/2	_____	\$
_____	Old returned { Long 4-1/2 x 5-1/2	_____	\$
_____	Ft. _____ in. { Copper	Pipe at _____	\$
_____	G.I. } _____		
_____	C.I. } _____		
_____	Nipples _____ in. at _____		\$
_____	Bushings _____ to _____ in. at _____		\$
_____	Red'g _____		
_____	Inc'g _____		
_____	Union _____ in. at _____		\$
_____	Meter _____ in. at _____		\$
_____	_____		\$
_____	Compound Joints at _____		\$
_____	Maintenance Foreman _____		\$
_____	Hrs. Water Maint. Man - 1 at _____		\$
_____	Hrs. Water Maint. Man - 2 at _____		\$
_____	Hrs. Garage Foreman _____ at _____		\$
_____	Hrs. Labor _____ at _____		\$
_____	Hrs. Compressor at _____		\$
_____	_____		\$
_____	Trucking _____		\$
_____	Pav't Patch _____		\$
_____	_____		\$
_____	_____		\$
DIX AVE. St. _____
 _____ Pl. _____
 _____ Ave. No. 186

Name of Owner _____

Labor and Mat'l. Report 6/5/18

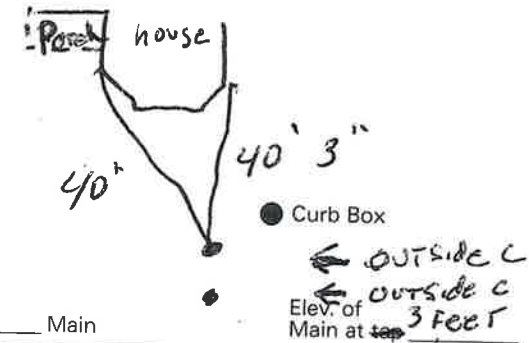

_____ Main
 Gate at ● _____ Gate at ●

● Curb Box
OUTSIDE CLEAN OUTS
TWO (T.M. D.B.)