

LABOR AND MATERIALS

- 2" ~~Lead~~ Copper } Connection _____ \$ _____
- _____ Curb } Cock Valve } _____ in. _____ \$ _____
- _____ } T.S. & V. }
- _____ Service box { Short 3-1/2 x 4-1/2 } _____ \$ _____
- _____ Old returned { Long 4-1/2 x 5-1/2 }
- 47 Ft. 7 in. ~~Galv.~~ Copper } Pipe at _____ \$ _____
- comp. Nipples _____ in. at _____ \$ _____
- _____ Bushings _____ to _____ in. at _____ \$ _____
- _____ Red'g _____
- _____ Inc'g _____
- _____ Union _____ in. at _____ \$ _____
- _____ Meter _____ in. at _____ \$ _____
- _____ \$ _____
- _____ Compound Joints at _____ \$ _____
- _____ Maintenance Foreman _____ \$ _____
- _____ Hrs. Water Maint. Man - 1 at _____ \$ _____
- _____ Hrs. Water Maint. Man - 2 at _____ \$ _____
- _____ Hrs. Garage Foreman _____ at _____ \$ _____
- _____ Hrs. Labor _____ at _____ \$ _____
- _____ Hrs. Compressor at _____ \$ _____
- _____ \$ _____
- _____ Trucking _____ \$ _____
- _____ Pav't Patch _____ \$ _____
- _____ \$ _____
- _____ \$ _____
- _____ \$ _____
- _____ \$ _____


TOTAL \$ 1092.00

DIX

St. 222 -
 Ave. No. 232

Name of Owner LAUNDROMAT/RETAIL

Labor and Mat'l. Report AUGUST 2, 2001

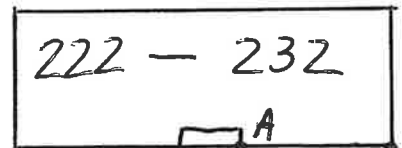

A = 82'6"
 B = 81'5"
 8" Main Elev. of Main at tap 5'

Gate at • DIX AVE. • Gate at

• Curb Box

LABOR AND MATERIALS

1	Copper Lead	3/4" Male Adapter Connection	\$
1	Curb	Cock Valve T.S. & V. } 3/4" in.	\$
1	Service box	Short 3 1/2 x 4 1/2	\$
Old returned	Long 4 1/2 x 5 1/2	Buff or Rdway	
50	Ft. 3/4 in.	Copper Pipe at	\$
2	Nipples 1 1/4 in.	at 6" Long galv.	\$
	Bushings	to in. at	\$
1	Red'g Inc'g	Tee Coupl'gs 1 1/4 to 3/4 in. at	\$
1	Union	1 1/4 in. at Dresser	\$
	Meter	in. at REPAIR sleeves	\$
	Lead Joints	at	\$
	Compound Joints	at	\$
	Maintenance Foreman		\$
	Hrs. Water Maint. Man	1 at	\$
	Hrs. Water Maint. Man	2 at	\$
	Hrs. Garage Foreman	at	\$
	Hrs. Labor	at	\$
	Hrs. Compressor	at	\$
	Compensation Ins.	at \$ per C	\$
	Trucking		\$
	Pav't Patch		\$
	Tap by Miller & Co.		\$
	4-15-58		\$
	O'head		\$

✓ RAZED P

Dix

St. Pt. Ave. No. 222

Name of Owner Adirondack Dist. Co.

Labor and Mat'l. Report Apr. 15 1958

N. ↑ see below.

N.Y. Power Pole #9

Pole ⊕ 9' Curb Box

1 1/4" Galv. Main Elev. of Main at tap 5'

Gate at • Gate at •

71' 12" N. 54' N

222 DIX AVE.

LSM-SC-2-5 56

222
DIX Ave.



N. 54'

71' 4"

● Curb Box

● Gate at

● Gate at

Elev. of
Main at tap

5'

Main

1 1/4" Galv.

● Curb Box



Pole

9'

N.Y. Power Pole #9



N.

see below.

Labor and Mat'l. Report Appr. 15 1958

Hd. Ironhack Dist. Co.

Name of Owner

St.
No. 222

DIX

RAZED

