


LABOR AND MATERIALS

Copper	} Connection		\$		
Lead					
Curb	} Cook Valve T.S. & V.	} 8 in.	\$		
				} Service box	} Short 3 1/2 x 4 1/2
		} Buff or Rdway	\$		
32 Ft.	8 in.			} <del>Copper</del> C.I.	} Pipe at
Nipples	in. at	\$			
Bushings	to in. at	\$			
Red'g Inc'g	} Coupl'gs.	to in. at	\$		
Union				in. at	\$
Meter	in. at	\$			
Lead Joints	at	\$			
Compound Joints	at	\$			
Maintenance Foreman		\$			
Hrs. Water Maint. Man	1 at	\$			
Hrs. Water Maint. Man	2 at	\$			
Hrs. Garage Foreman	at	\$			
Hrs. Labor	at	\$			
Hrs. Compressor	at	\$			
Compensation Ins.	at \$ per C	\$			
Trucking		\$			
Pav't Patch		\$			
Sprinkler + Domestic Water		\$			
O'head		\$			

Dix -Str  
-Pl  
Ave. No. 230

Name of Owner  
Claude Charlebois

Labor and Mat'l. Report December 1979

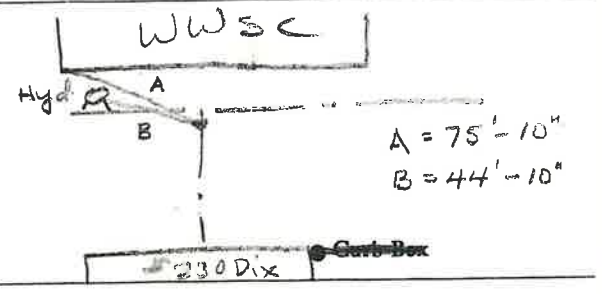

8" Main Elev. of Main at tap 5 1/2'

Gate at ● ● Gate at

● Curb Box

Sprinkler + Domestic Water