

LABOR AND MATERIALS

1	Copper Lead	} Connection	3/4		\$ 1.35
1	Curb	{ Cock Valve T. S. & V.	3/4	in.	\$ 1.80
1	Service Box Old returned	{ Short 3 1/2 x 4 1/2 Long 4 1/2 x 5 1/2 Buffer Rdway.			\$ 1.70
13	Ft. 3/4	{ Copper Galv Iron Cast Iron		} Pipe at 18	\$ 2.34
	Nipples			in. at	\$
	Bushings			to in. at	\$
	Red'g Inc'g	{ Couplings		to in. at	\$
	Union			in. at	\$
	Meter			in. at	\$
	Lead Joints at				\$
	Leadite Joints at				\$
	Hrs. Foreman at				\$
1	Hrs. Chauffeur at		6 1/2		\$ 63
2 1/2	Hrs. Tapper at				\$ 1.56
9 1/2	Hrs. Labor at		45		\$ 4.28
	Hrs. Labor at				\$
	Hrs. Compressor at				\$
	Compensation Ins.				\$ 20
	Trucking				\$ 1.-
	Builders Use of Water	Before Putting			\$
					\$
					\$
					\$ 14.86

181 1941

St.
Pl.
Ave. No. 15


Dix

Name of Owner

Mary Fitzgerald

Labor and Mat'l. Report

Oct 14 1941

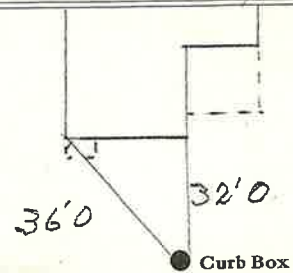

4"

Main

Elev. of
Main at tap

5'

Gate at ●

● Gate at

● Curb Box